



Garage Door Elevation & Section  
 E: 1/4" = 1'-0"


BHAC Approved  
 Plan  
 1/17/17

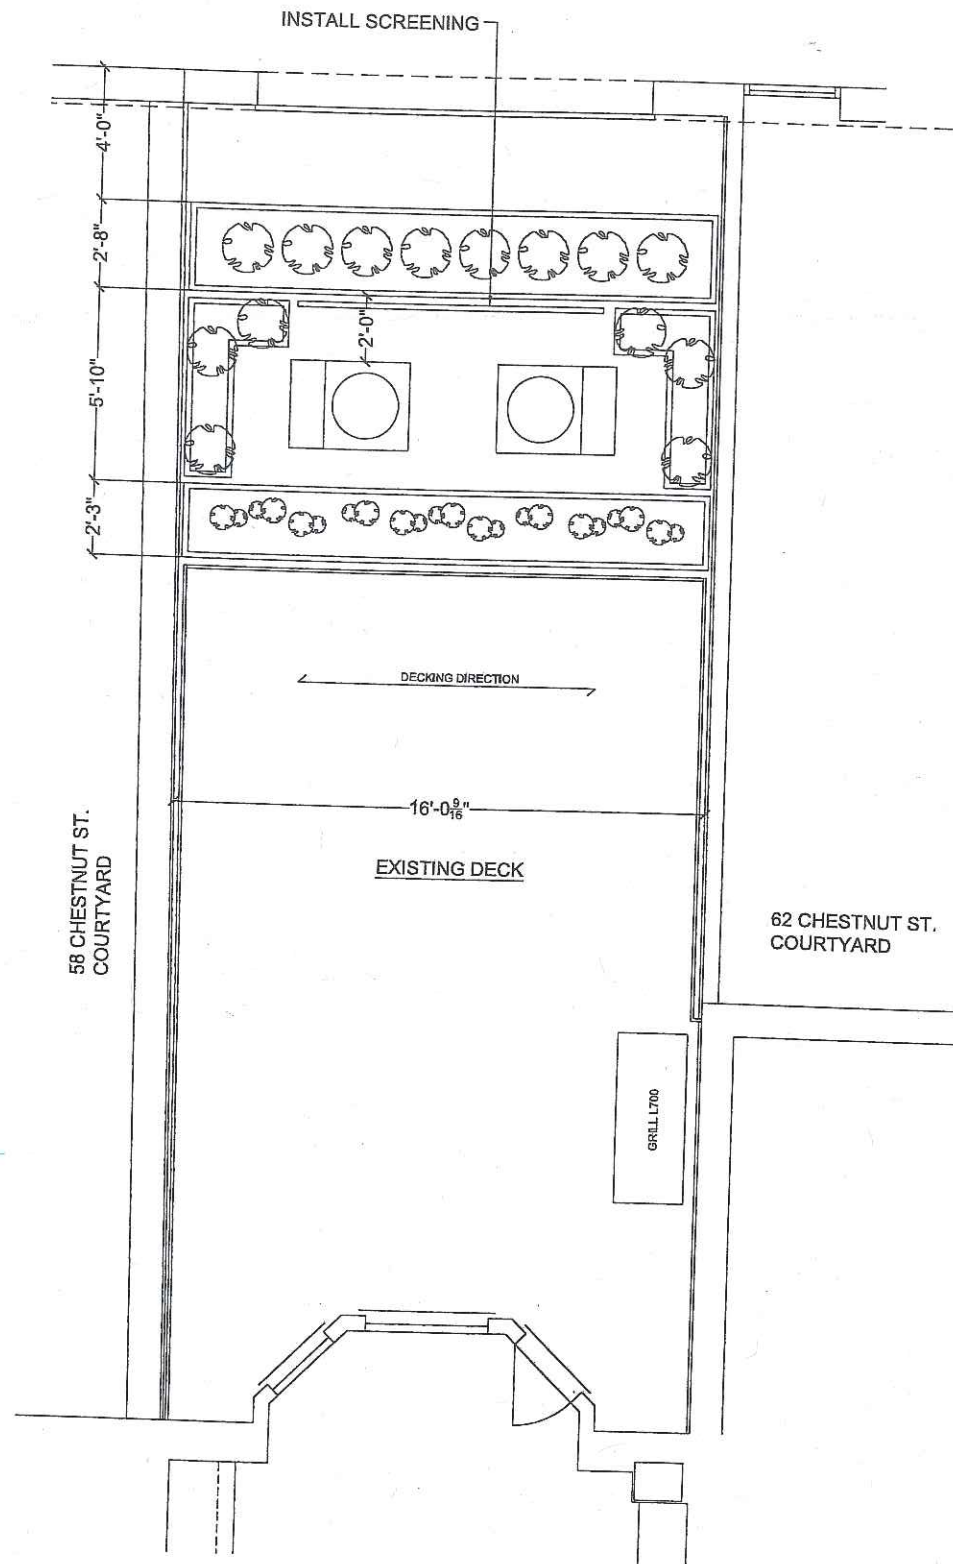

EXISTING DECK PLAN  
SCALE: 3/8" = 1'-0"

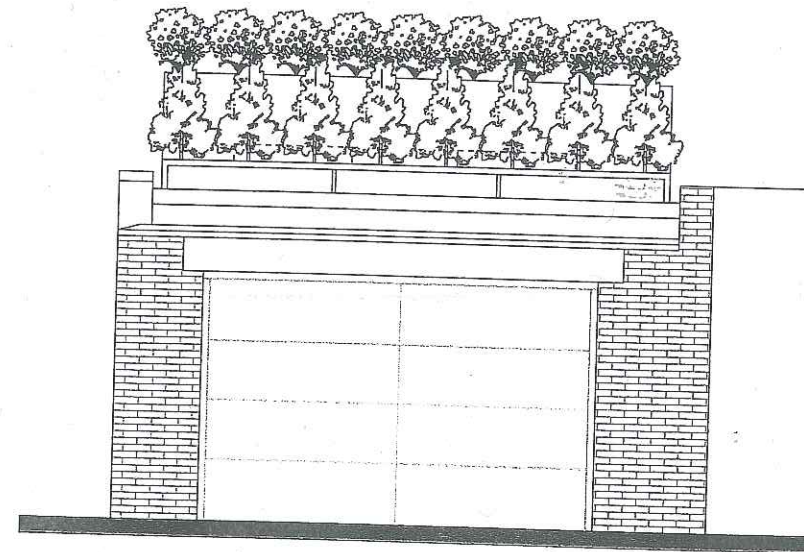


REAR ELEVATION  
SCALE: 3/8" = 1'-0"

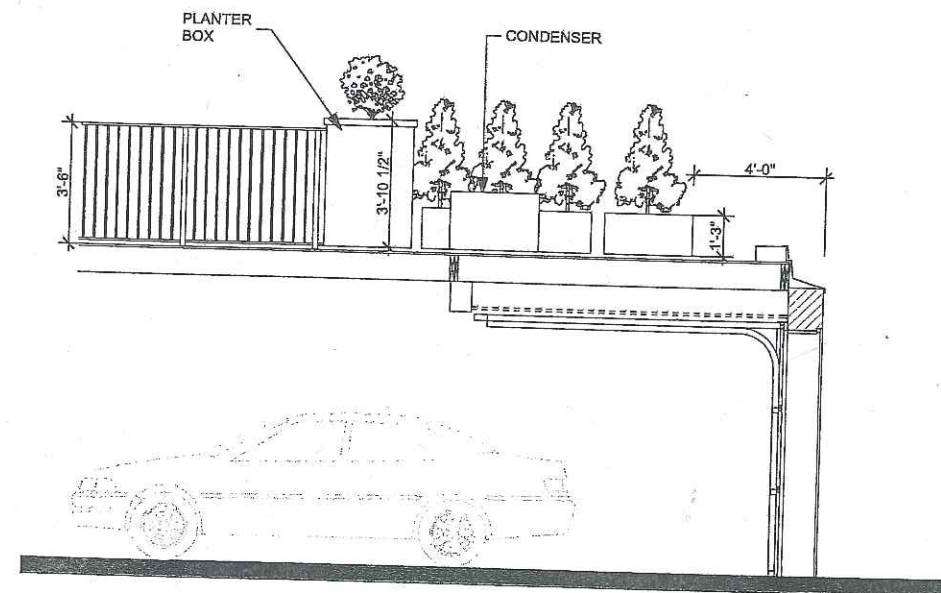

CROSS SECTION  
SCALE: 3/8" = 1'-0"

Deck As Built

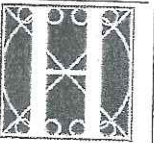

the HOLLAND COMPANIES

Design & Construction

1126 Main Street  
Weymouth, MA  
02190

Phone: 781.355.4276  
Fax: 781.340.0077

thehollandcompanies.com

12/10/18

PAGE INFORMATION:

Sections

REVISION/DATE:

PRINT DATE:

7/5/2018

ISSUE DATE:







#Issue Date

PROJECT NAME:

60 Chestnut Street

UNIT:

60 Chestnut Street  
Boston, Ma

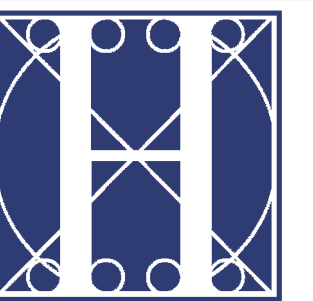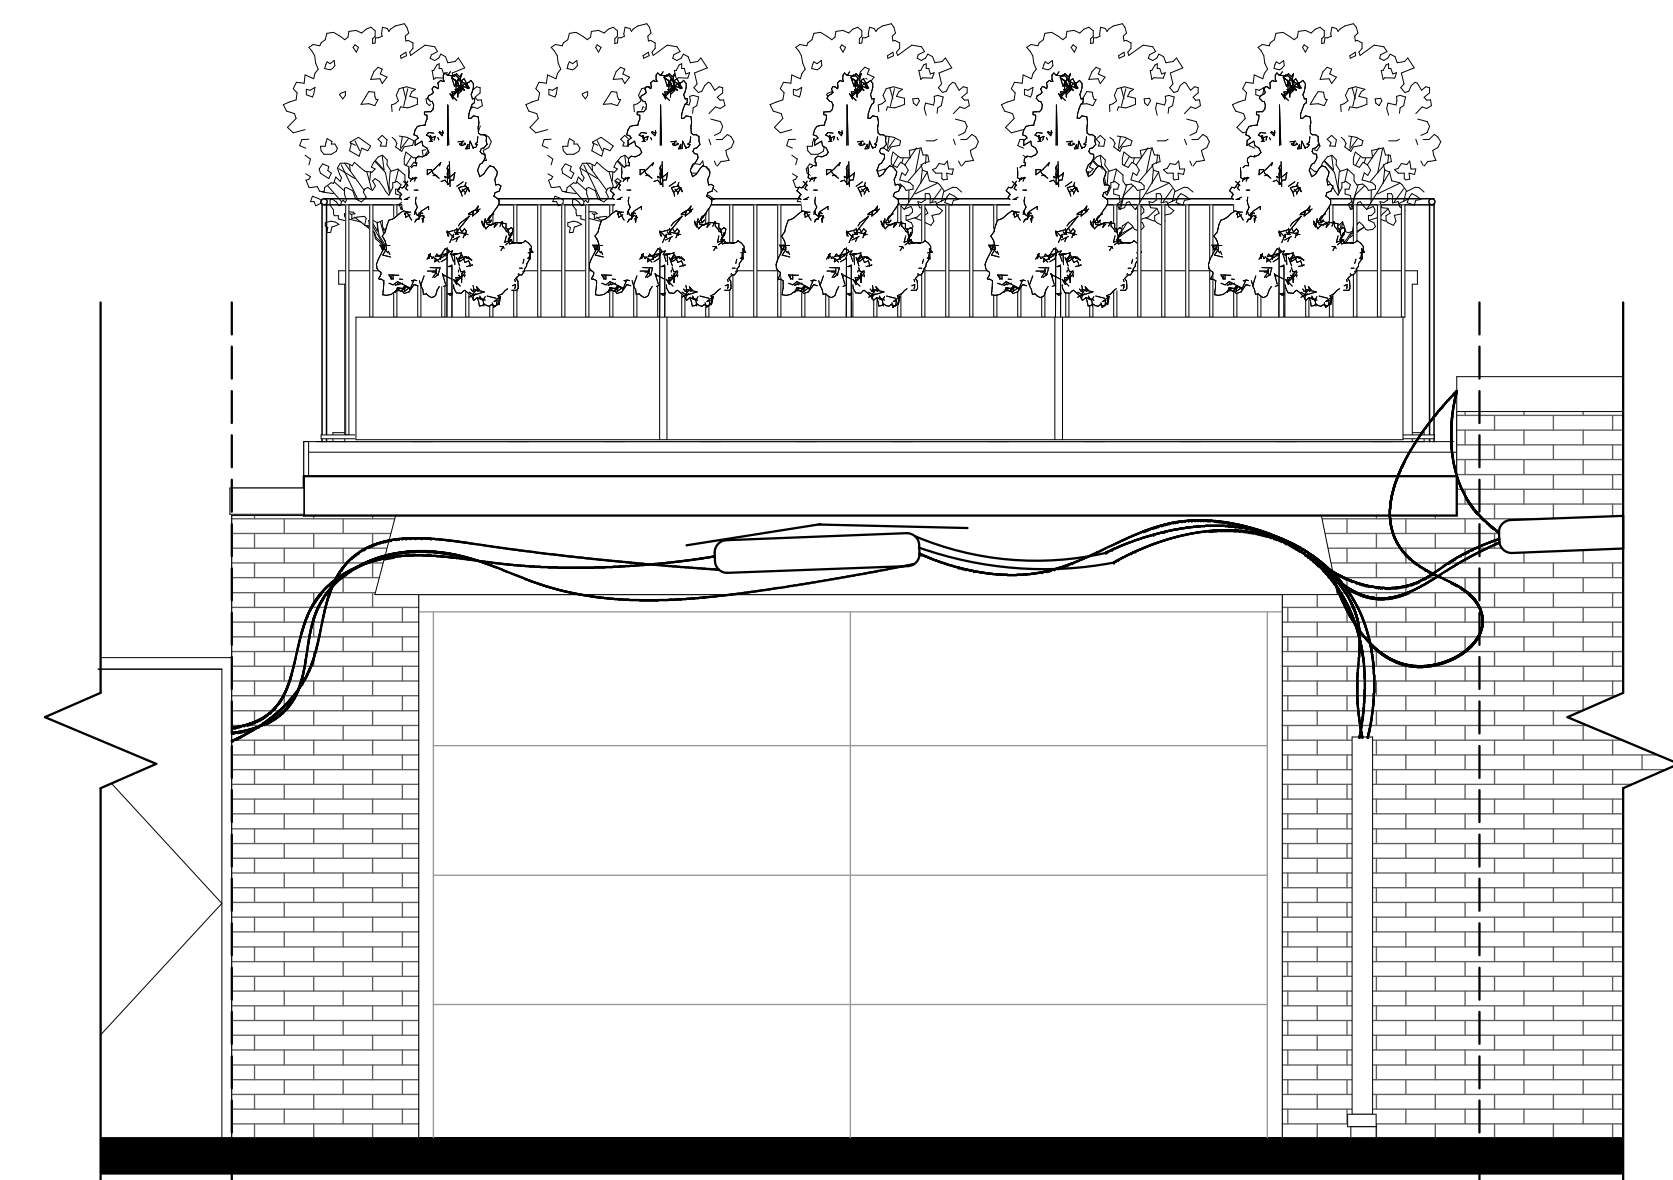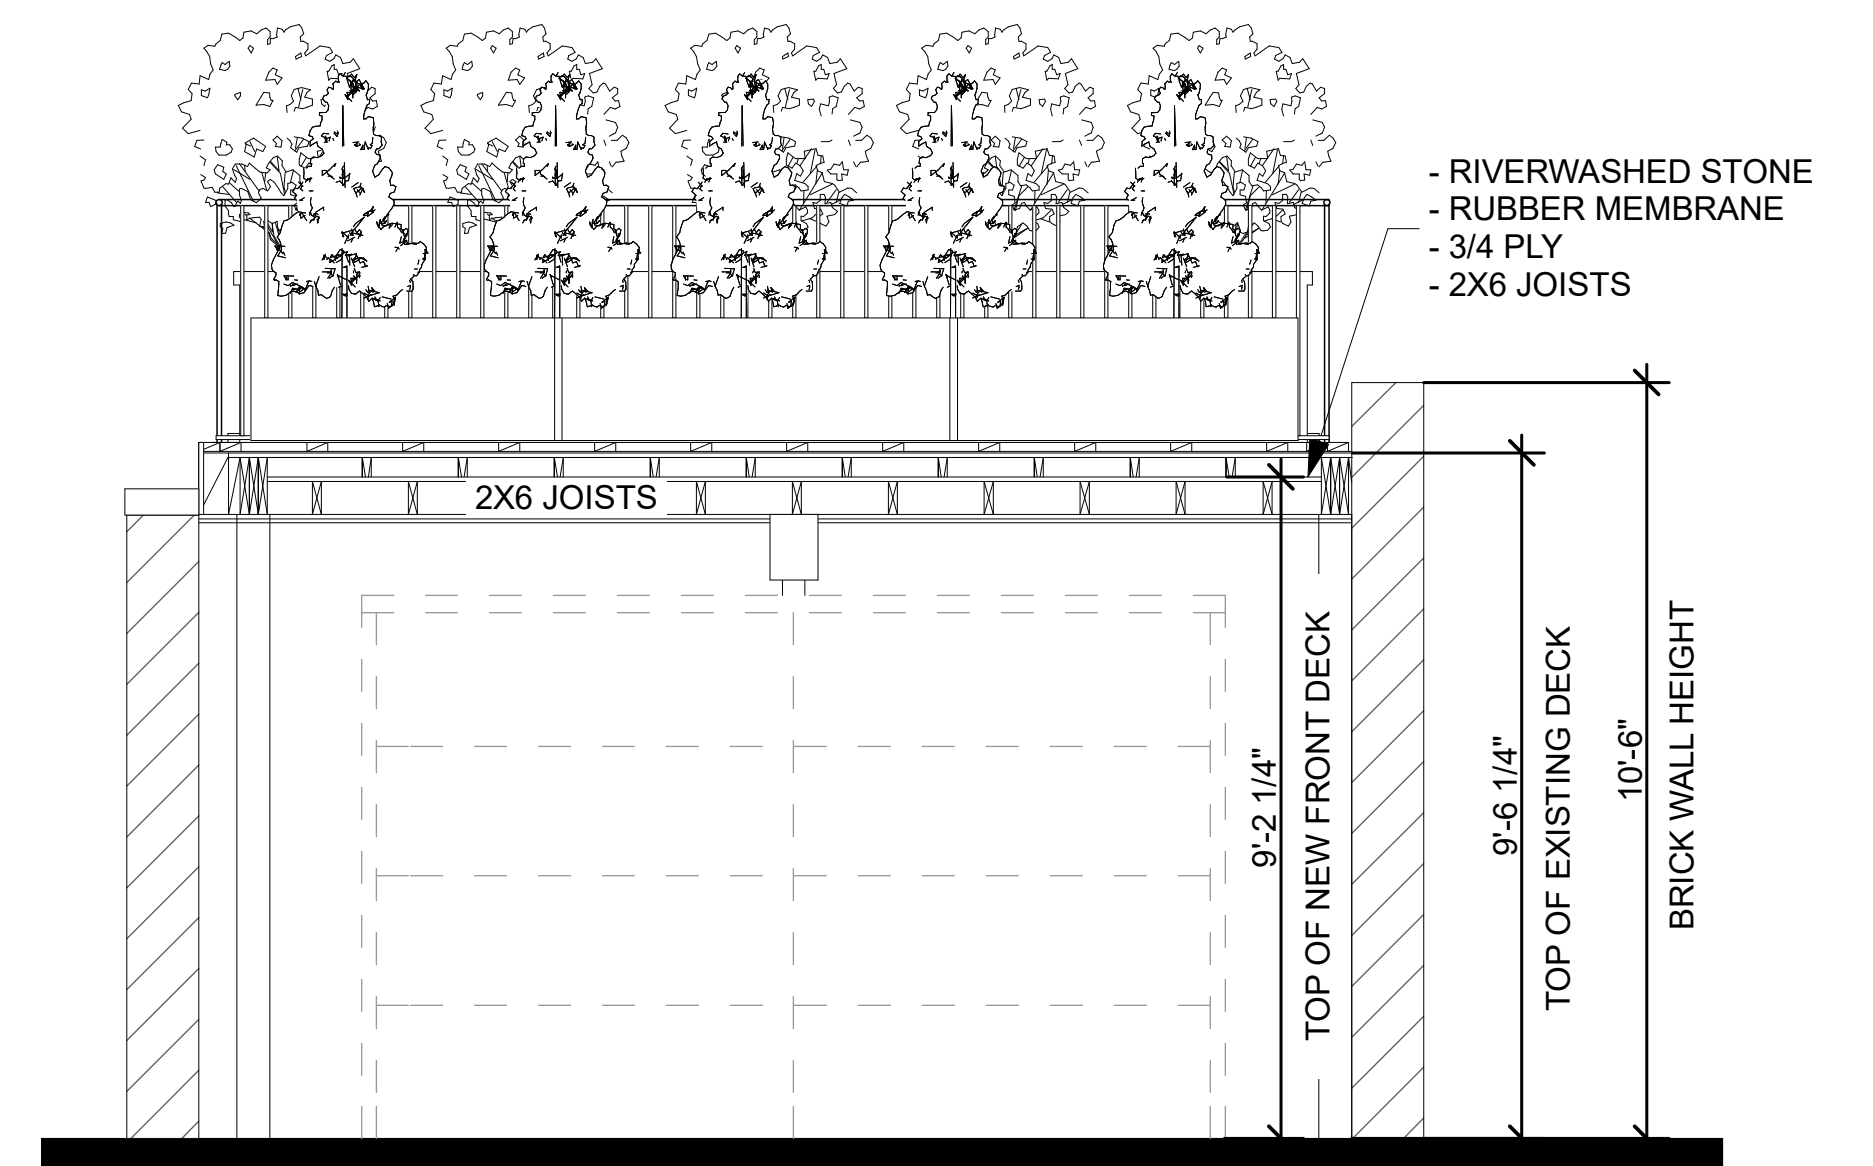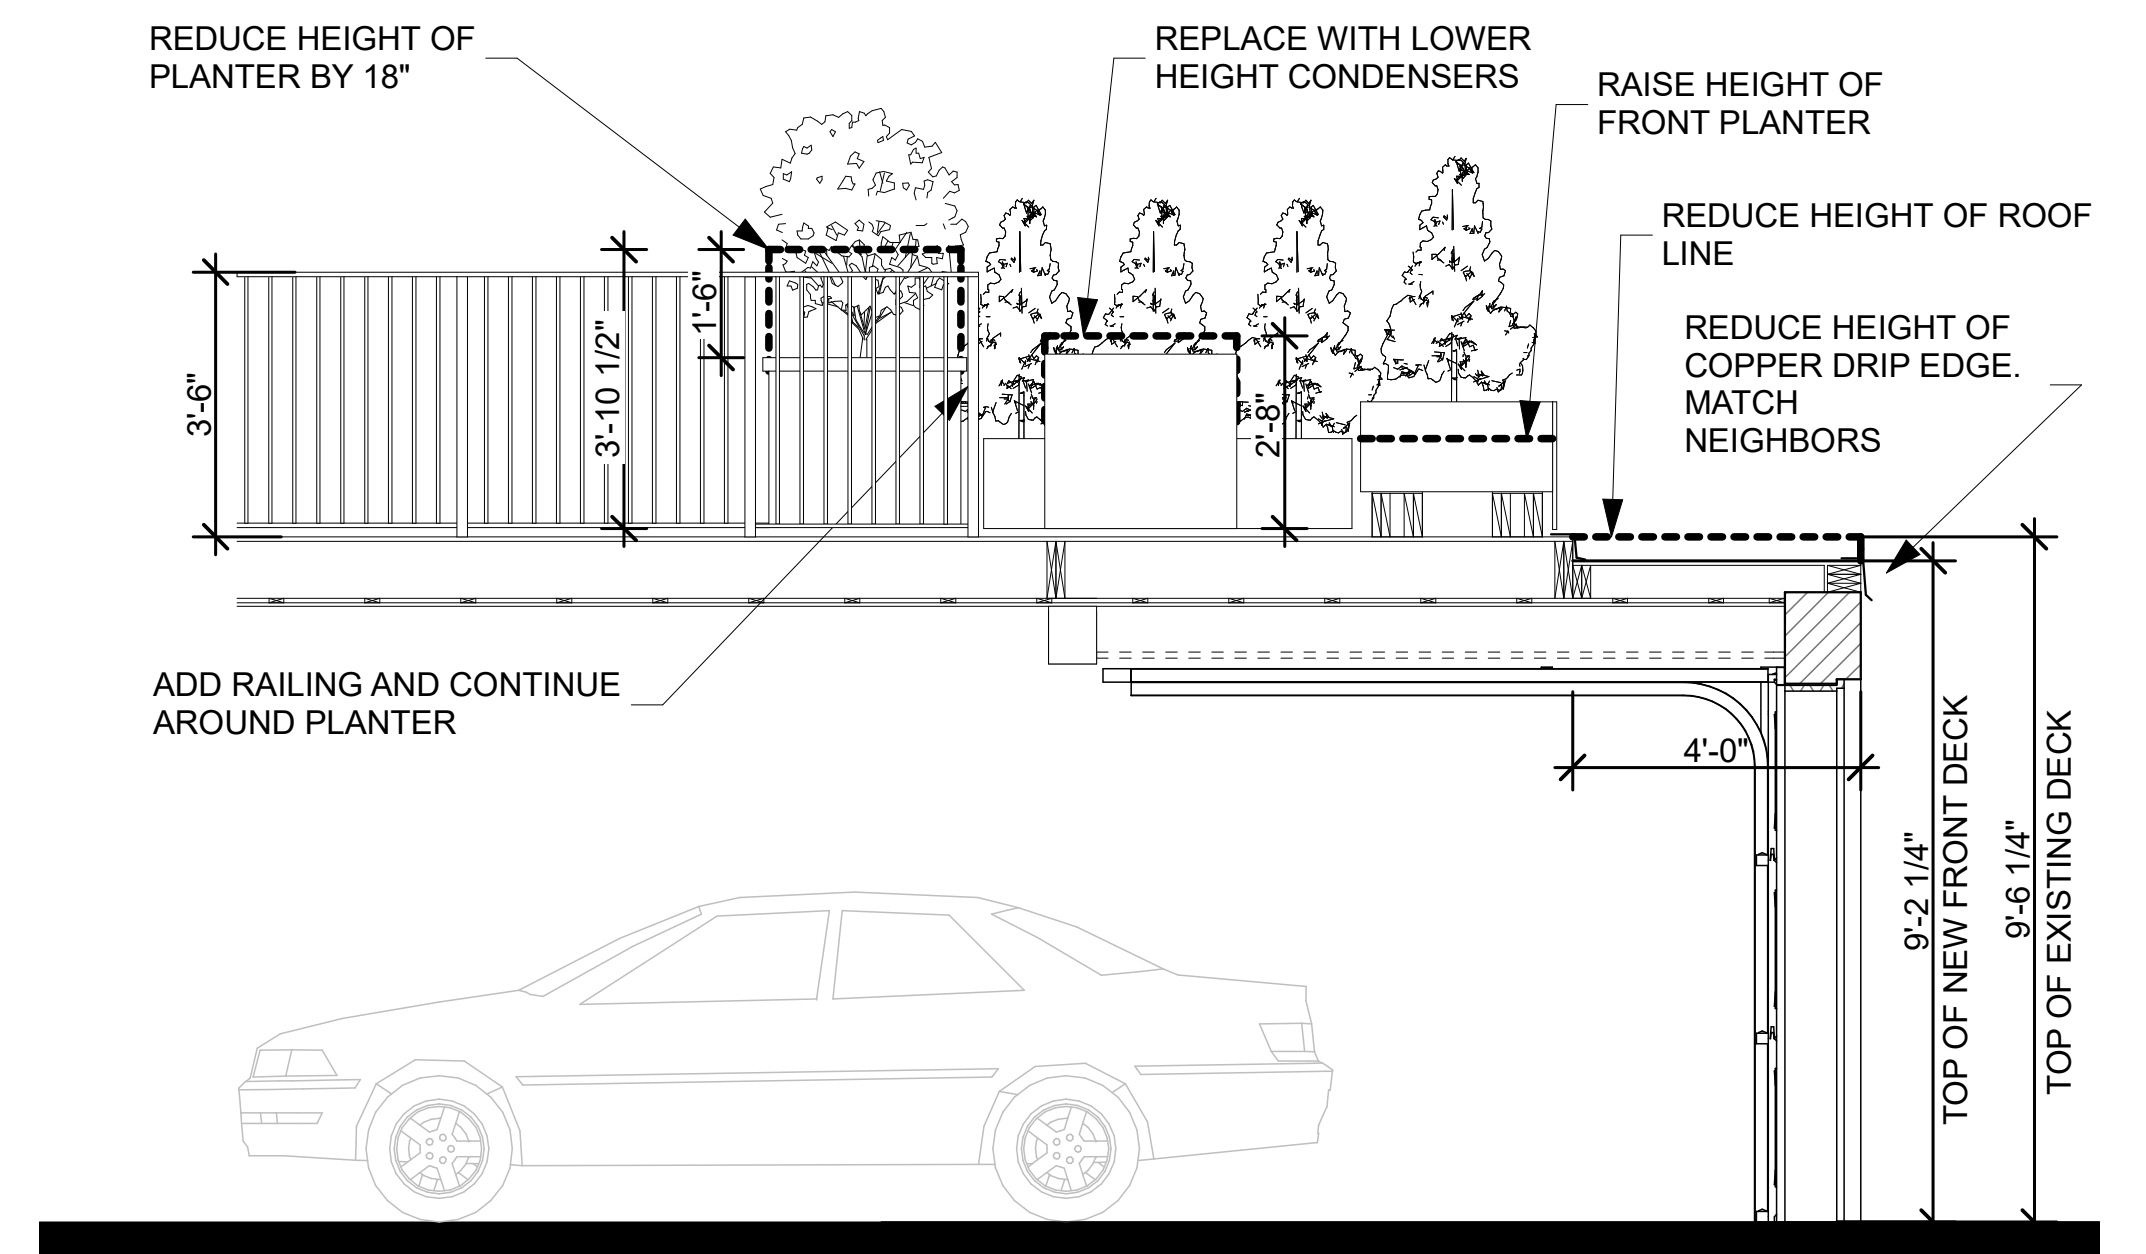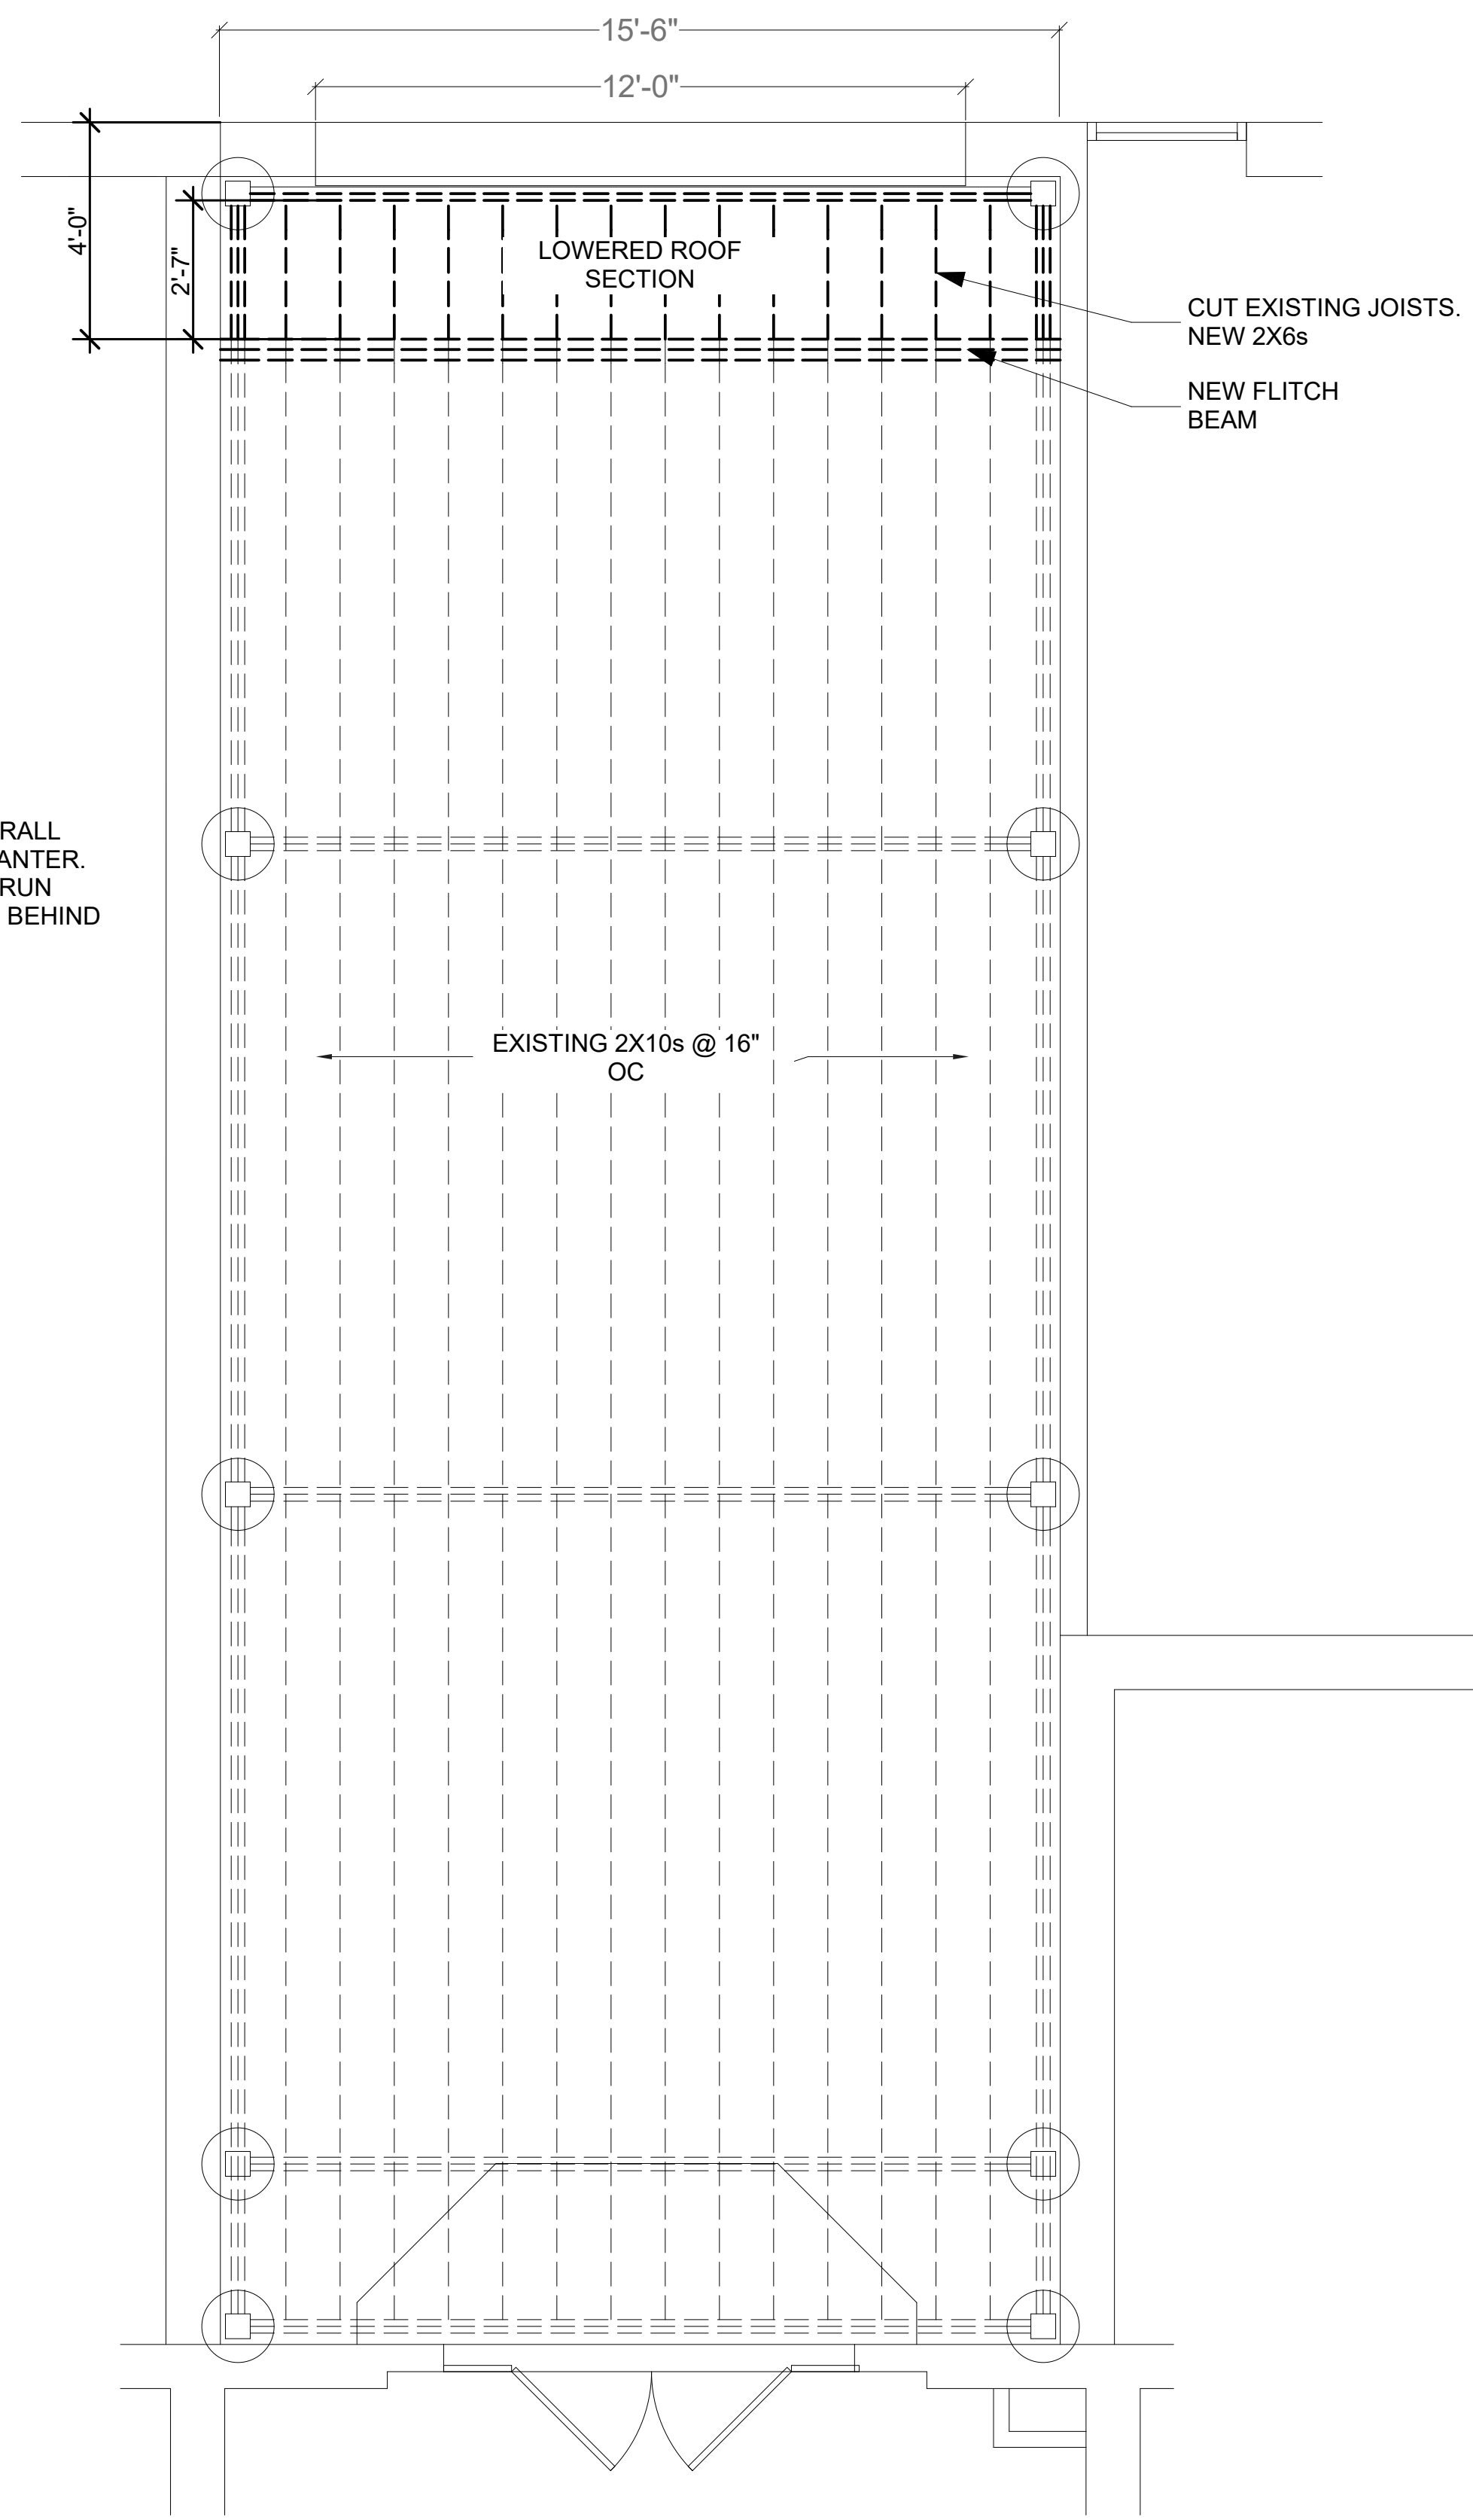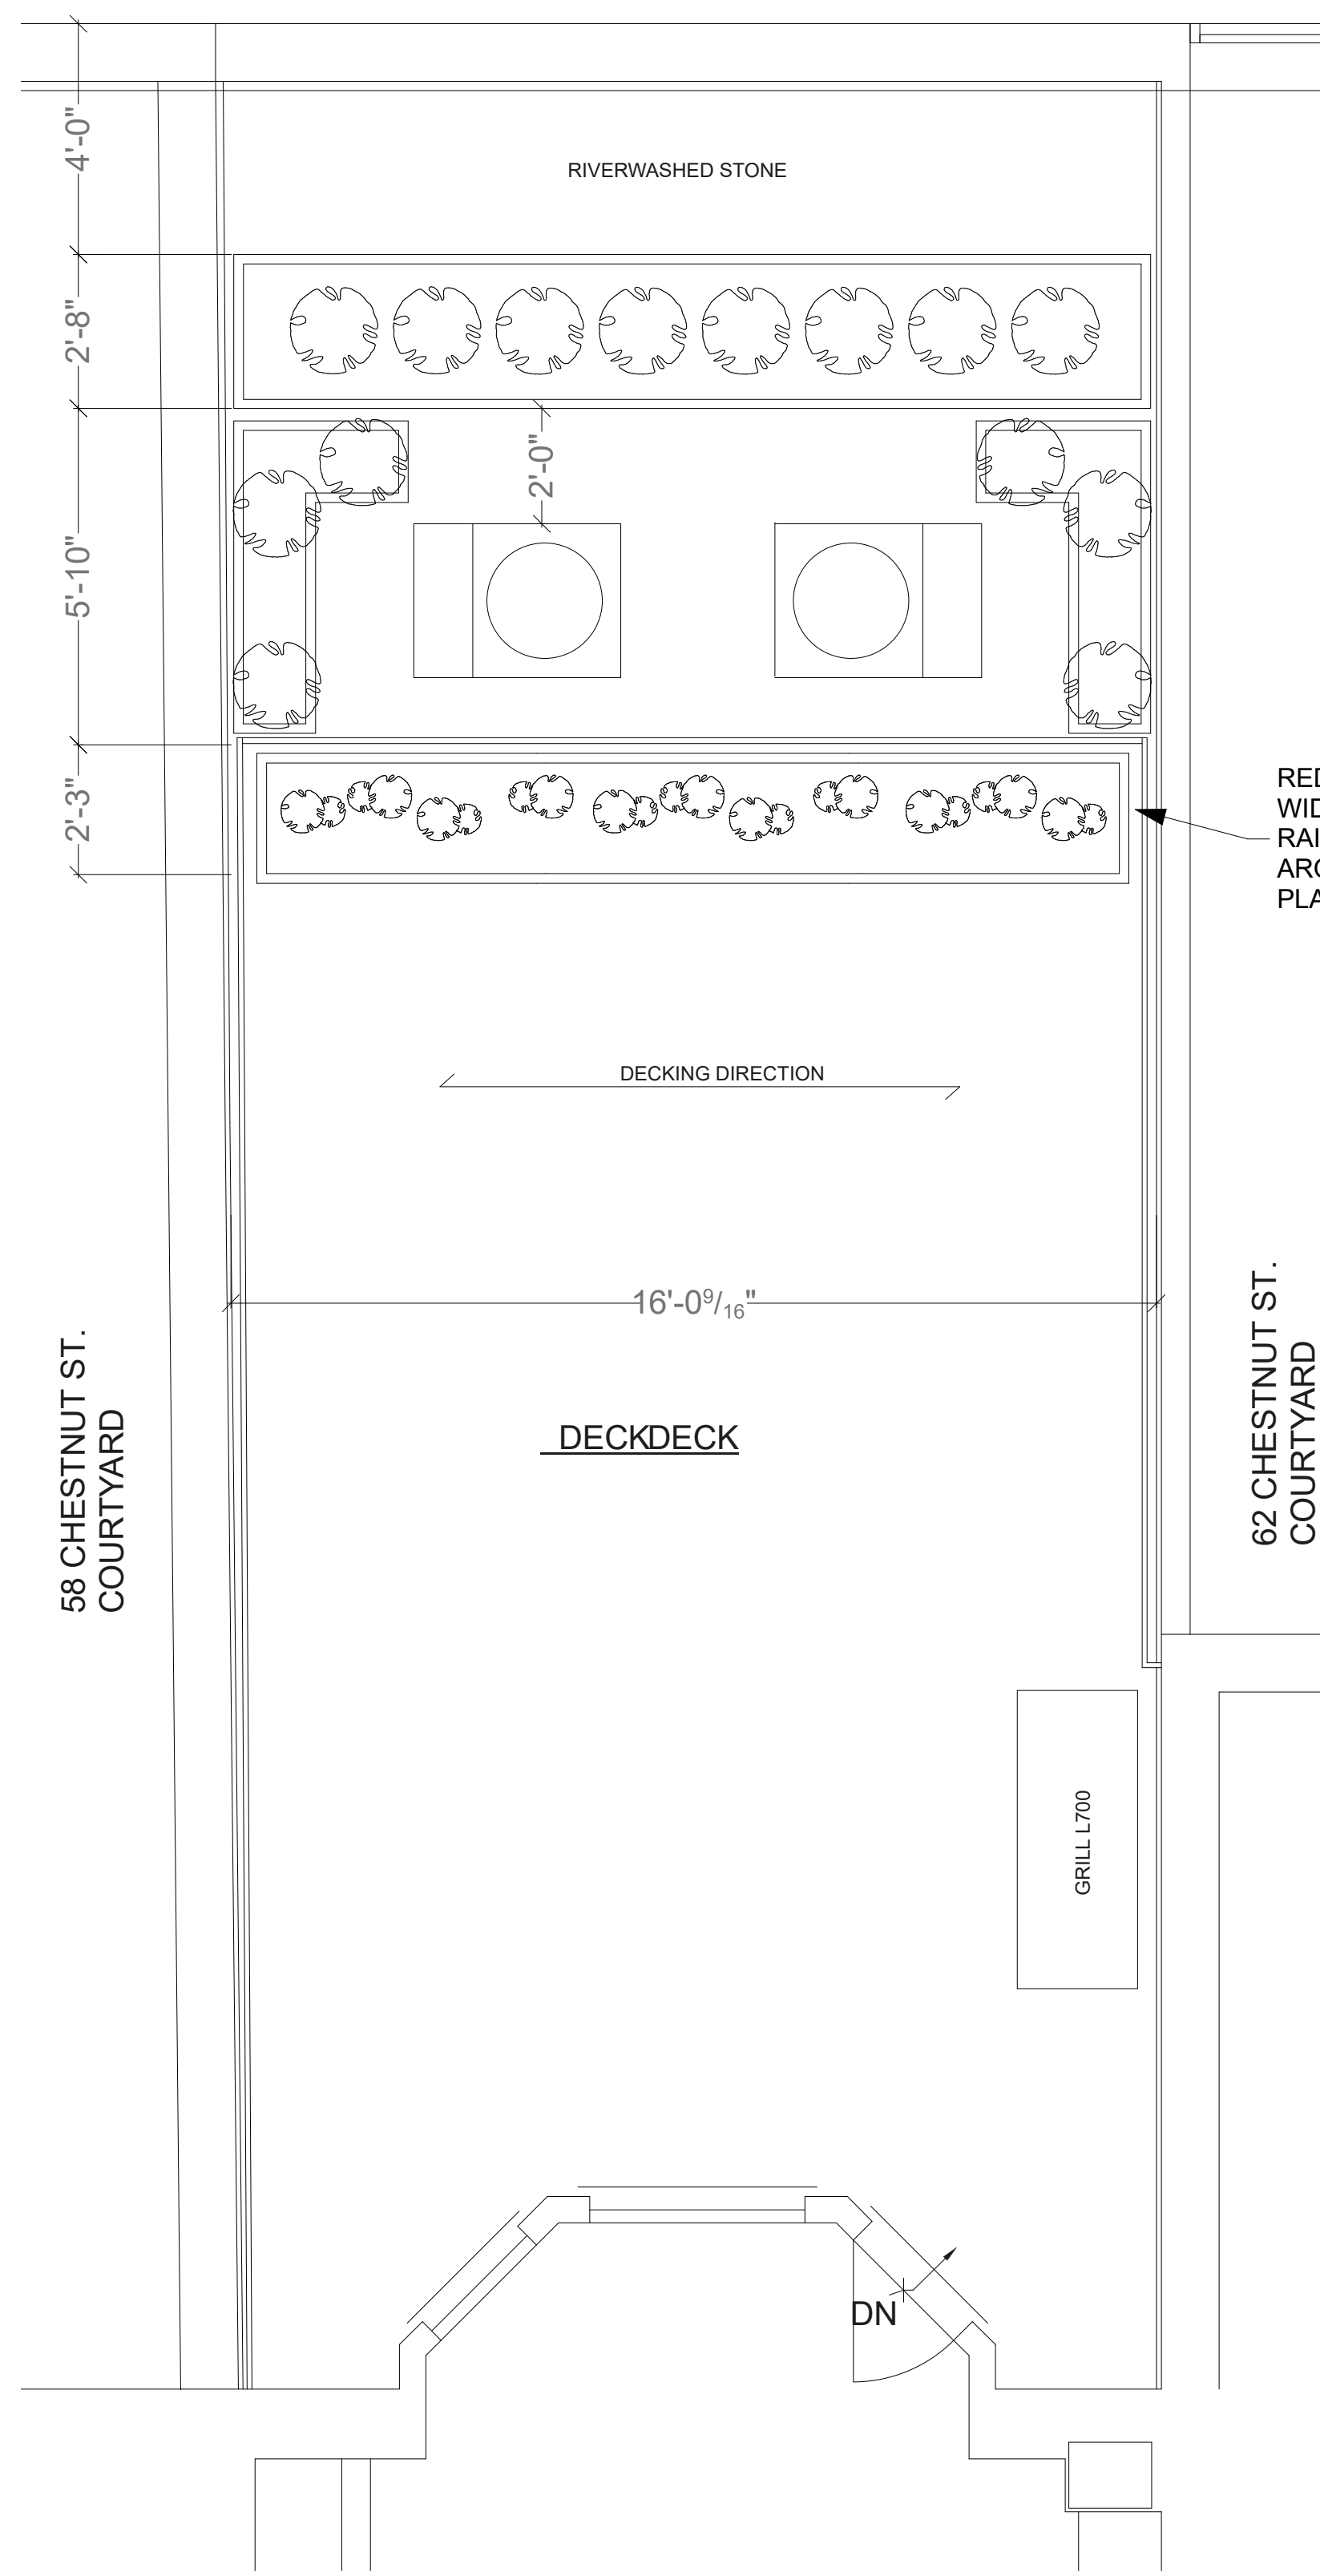

the  
**HOLLAND COMPANIES**  
Design & Construction

1126 Main Street  
Weymouth, MA  
02190

Phone 781.335.4275  
Fax 781.340.0077

thehollandcompanies.com

Reg Stamp Location

PAGE INFORMATION:  
Sections

PRINT DATE:  
12/4/2018

ISSUE DATE:  
#Issue Date

PROJECT NAME:  
60 Chestnut Street

PROJECT ADDRESS:  
60 Chestnut Street  
Boston, Ma





62



62



62









