



3

AS-BUILT GARAGE DOOR PHOTOGRAPH

FULL: 1/2" = 1'-0", HALF: 1/4" = 1'-0"



1

AS-BUILT GARAGE DOOR ELEVATION

FULL: 1/2" = 1'-0", HALF: 1/4" = 1'-0"

	Date: 1/27/2020	Door Qty: One	Inside Backer: Exterior Grade Plywood
	Quote No: Q7886	Wood Type: Extra	Edge Style: Quarter Round
	Dealer: DSI North	Inlay/Panel: Marine MDO	Glass Type: Clear True Divided DSB
	Customer: Phoenix Construction	Inlay Type: Vgrooved	Gl. Grid Type: 4 OV 4 Square
	Door Series: Charles River	No. Panels: Two	Arch Radius:
	Door Model: Cambria	No. Sections: Four	Exterior Finish: Paint Grade Primed
	Door Type: Sectional	Insulation: Polystyrene R-8	Door Thickness: 2-3/8"

WWW.EVERITEDOOR.COM


Please sign and date for approval:

Dimensions are Nominal. This door is a wood product. It must be painted or stained with the same number of coats of the same material on all 6 edges prior to installation otherwise warranty is void. Doors are factory sanded and must be sanded again prior to finishing.

2

AS-BUILT GARAGE DOOR SHOP DRAWING

FULL: 1/2" = 1'-0", HALF: 1/4" = 1'-0"

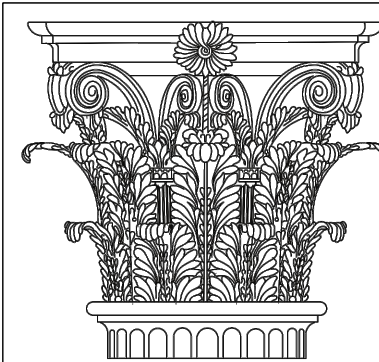

PAULI & URIBE
ARCHITECTS LLC
 Classic Architecture
 Interior Design
 121 Mount Vernon Street
 Boston, Massachusetts, 02108
 617 227 0954 • www.pauli-uribe.com

28 PINCKNEY STREET
 BOSTON, MA 02108

SHEET TITLE:
 AS-BUILT
 OVERHEAD GARAGE DOOR

DATE: FEBRUARY 22, 2021

SCALE: AS NOTED

DRAWN: JGUR & RJP

CHECKED: JGUR & MZP

SHEET NO.

A-1